
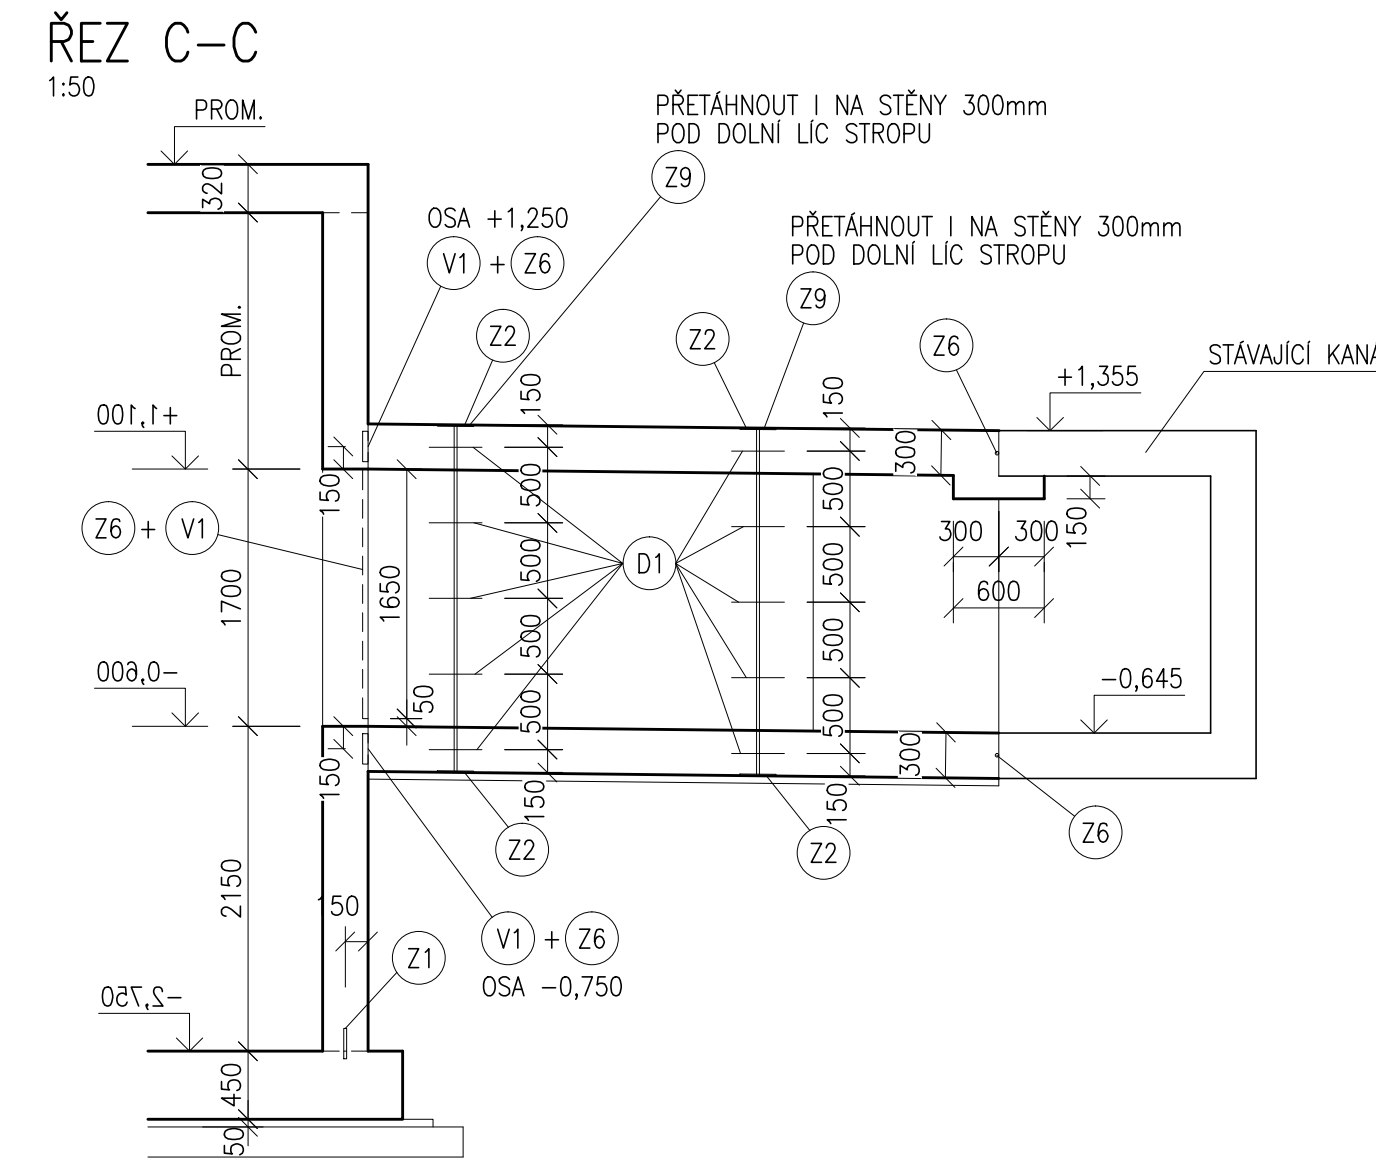


POHLEDOVÝ BETON
HLADKÁ PLOCHA
TRÍDA POHLEDOVOSTI PRS

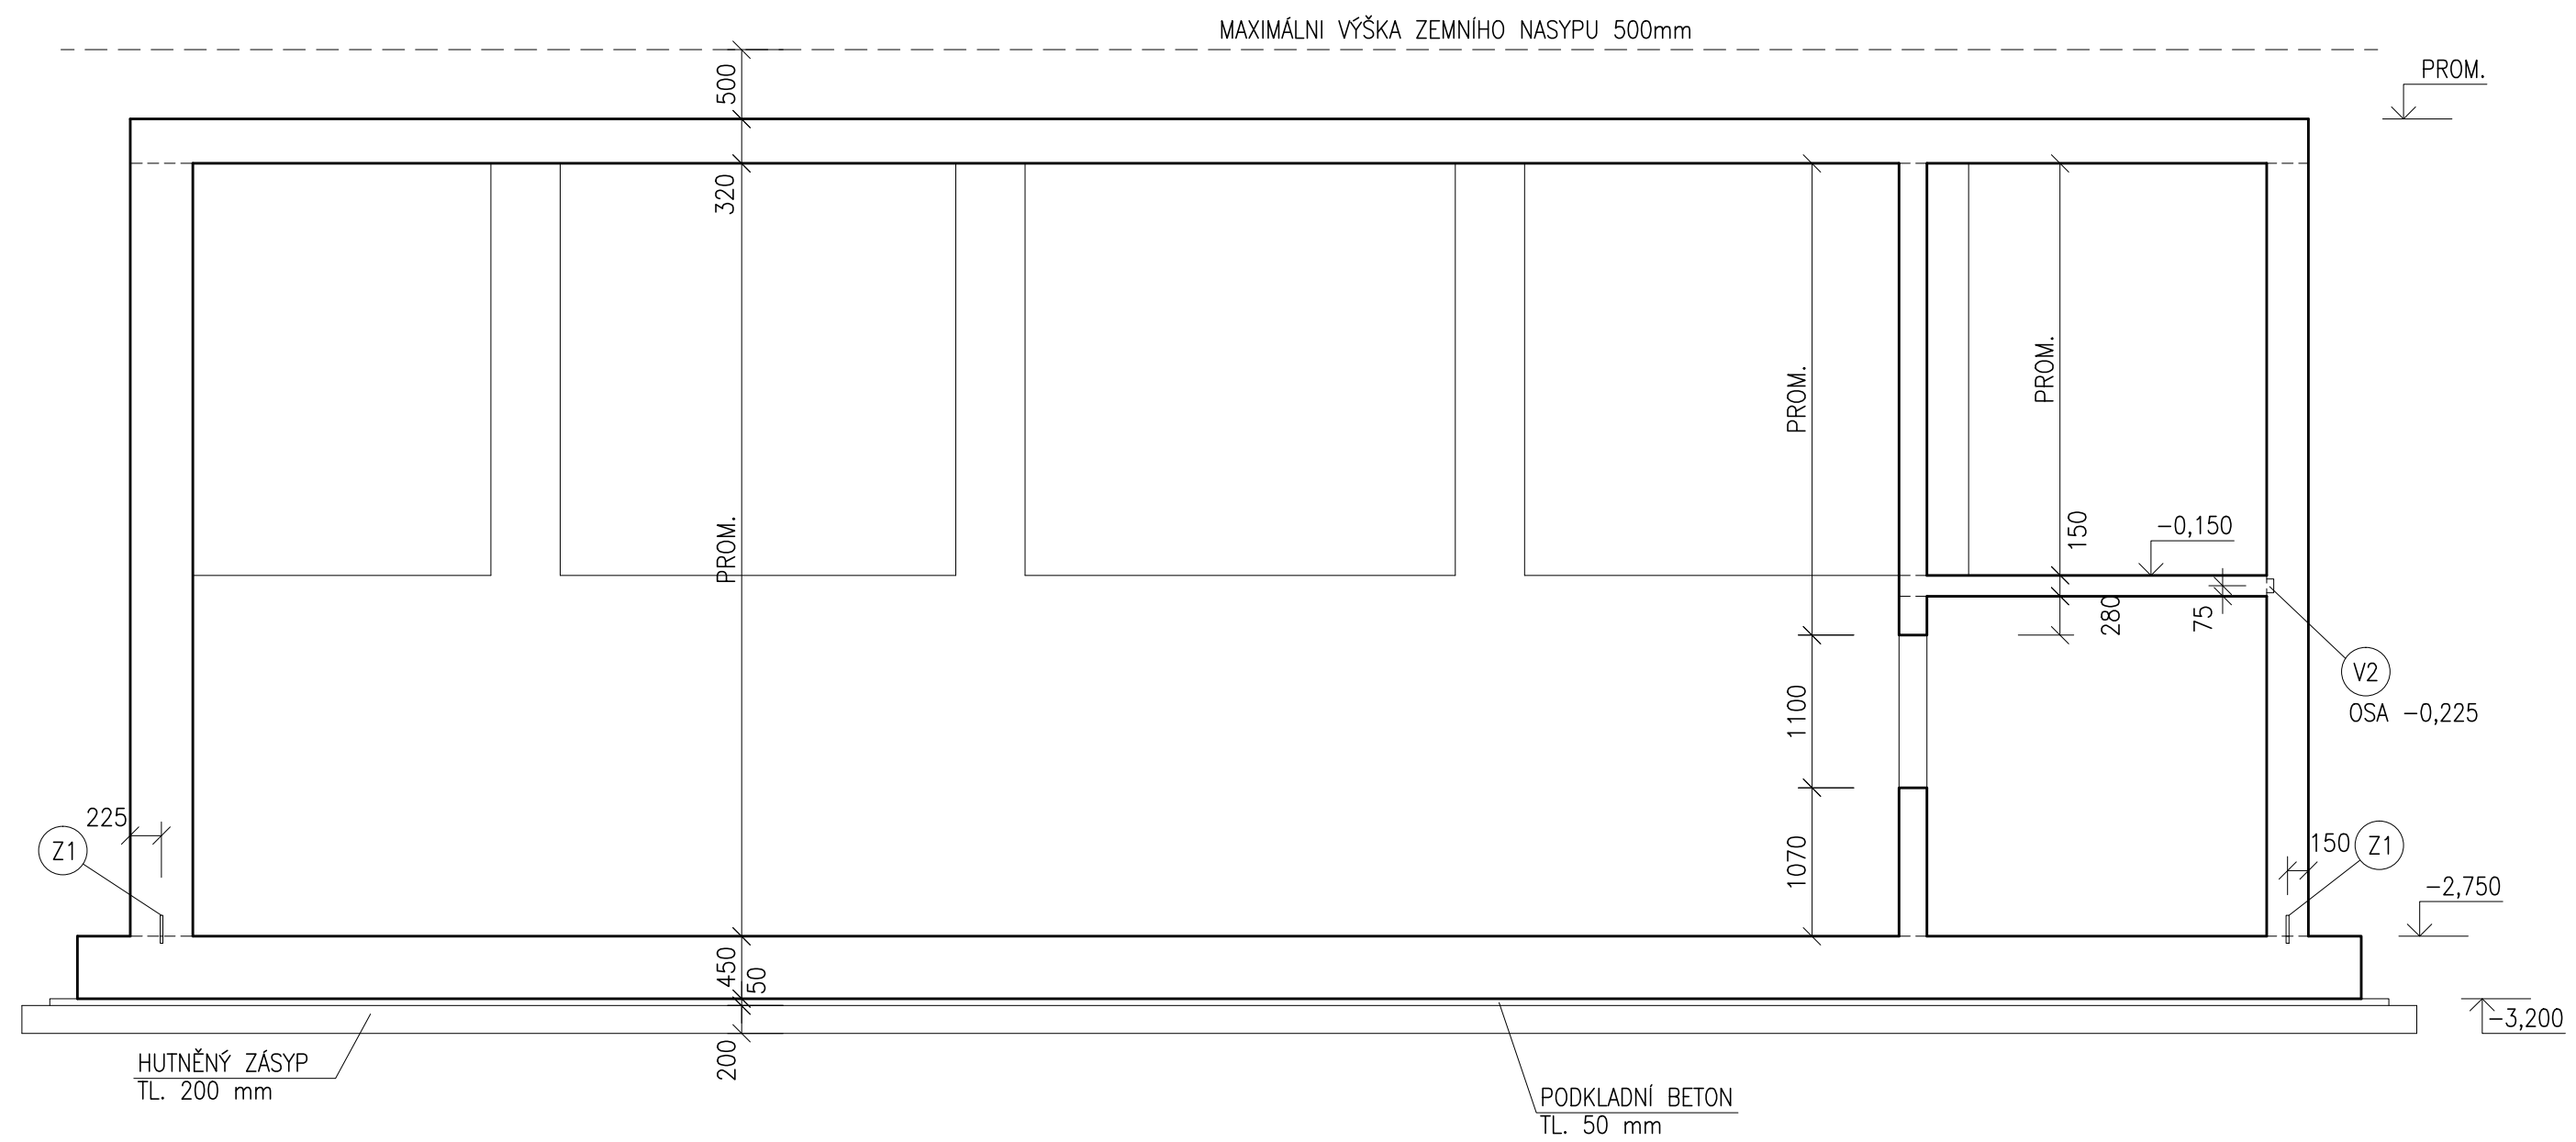



| |


$$\pm 0,000 = 228,950 \text{ m n.m.}$$

Revize	Vypracoval	Popis obsahu revize	Datum

		Hlavní inženýr projektu: ING. MILAN TOMEK Vedoucí projektové zakázky: ING. FILIP ŠPÁČIL		Investor:  FAKULTNÍ NEMOCNICE OLMOUC	
Profese: STATIKA		Zpracovatel dílu: HURÝTA s.r.o., Statkova 557/18a, 602 00 Brno Tel: +420 541 420 711 E-mail: huryta@huryta.cz		Autorizace:	
Odpovědný projektant: ING. LUKÁŠ LOUIDL		Vypracoval: ING. LUKÁŠ LOUIDL		Kontroloval: ING. LADISLAV HURÝTA	
Alko:		FAKULTNÍ NEMOCNICE OLMOUC CENTRÁLA A ROZVODY POTRUBNÍ POŠTY		Zakázkové číslo: SPS 51 - 2016	
Datum:		Datum: 09 - 2016		Part:	
Objekt: CENTRÁLA POTRUBNÍ POŠTY		SO 01		Formát: 14xA4	
Obsh:		Měřítko:		Číslo výkresu:	
ŘEZY - TVAR		1:50		D1.01.02-104	