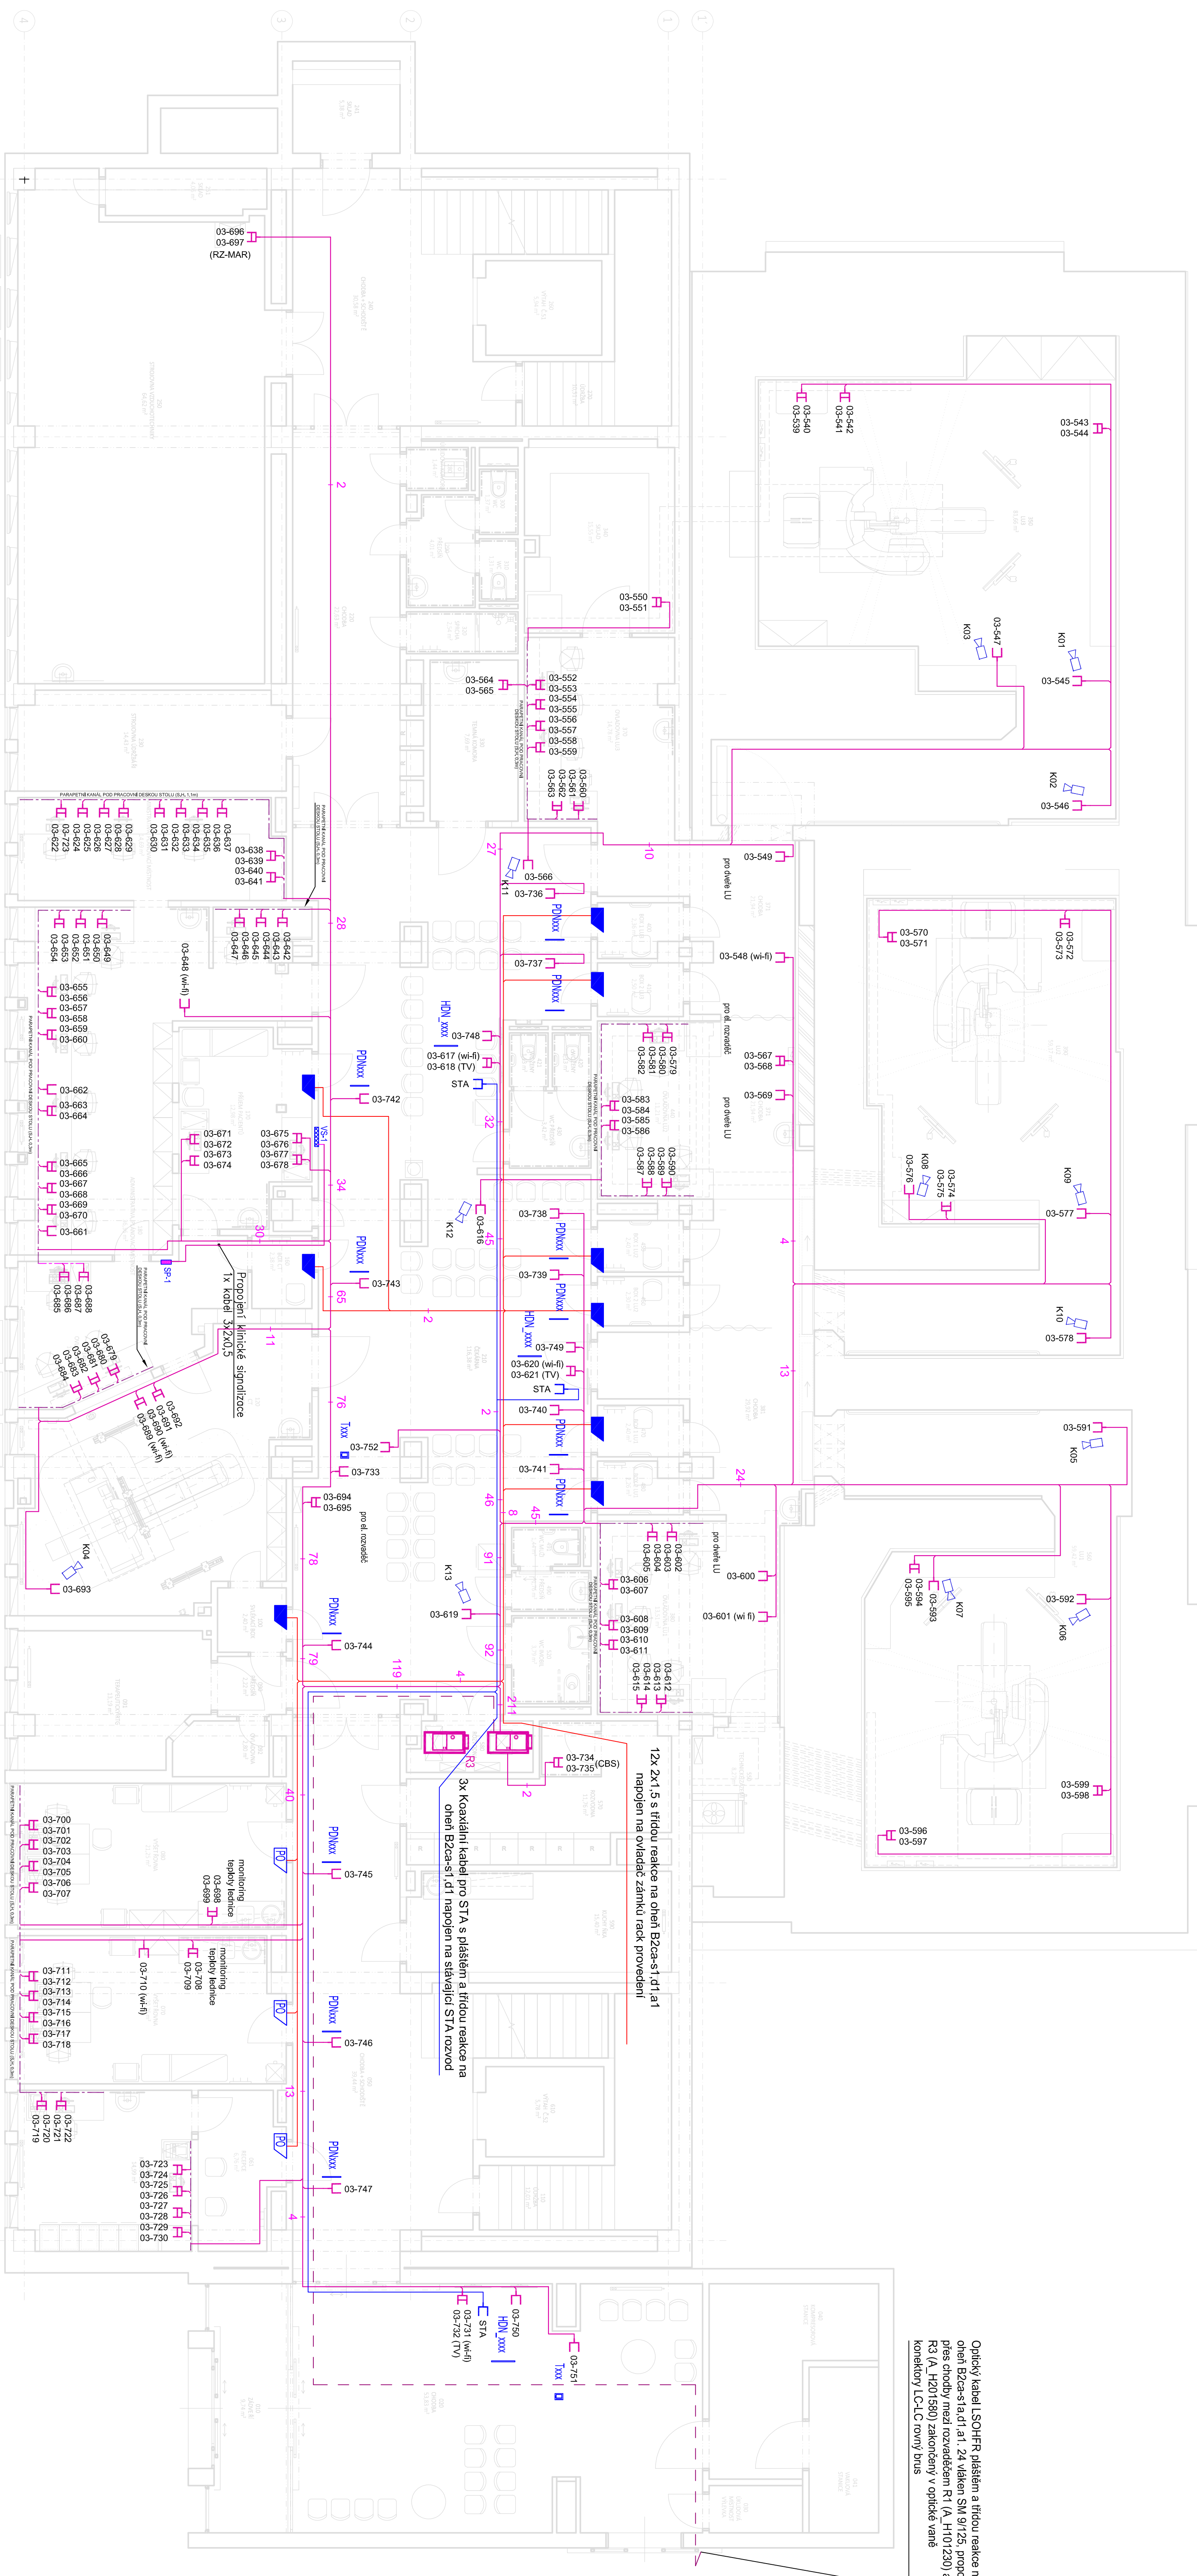
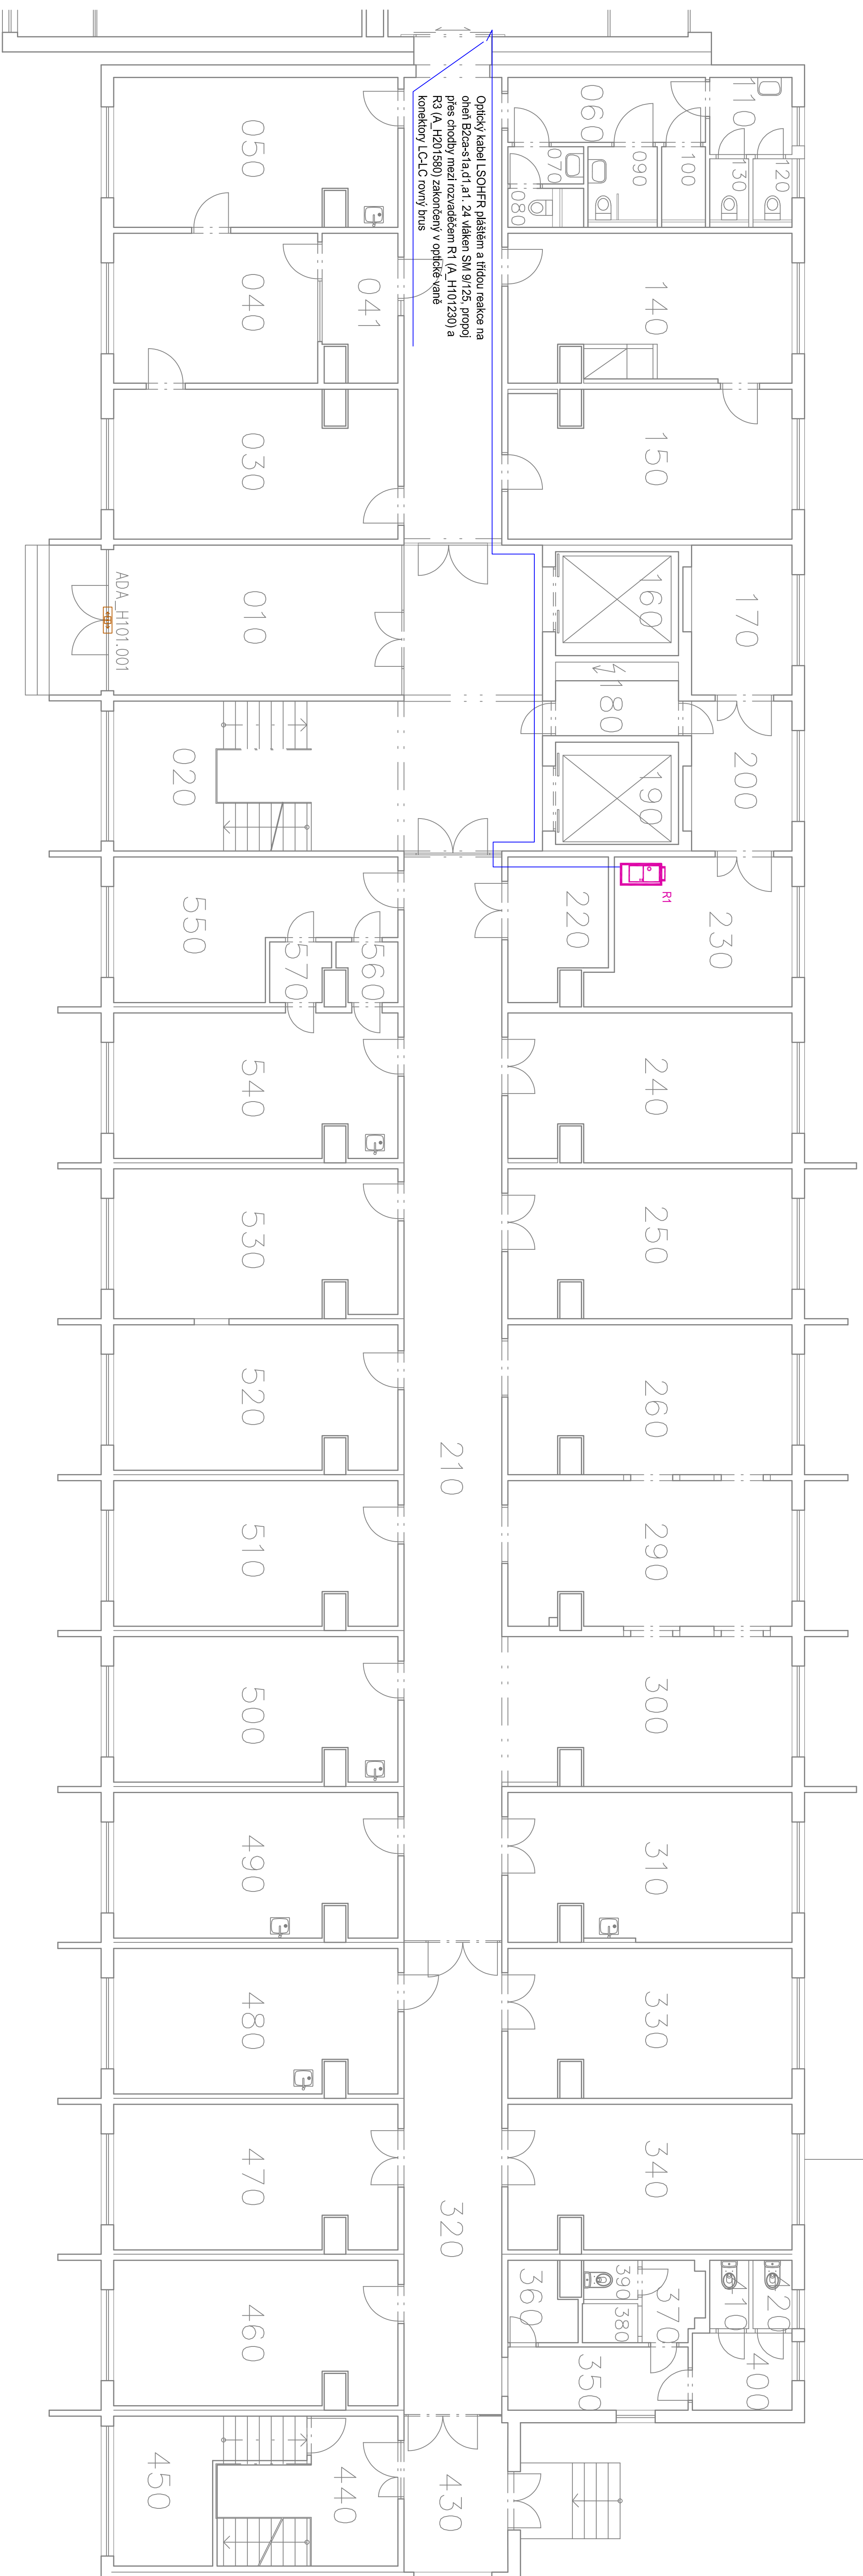


Budova H1
Púdorys 1NP

[illegible]