


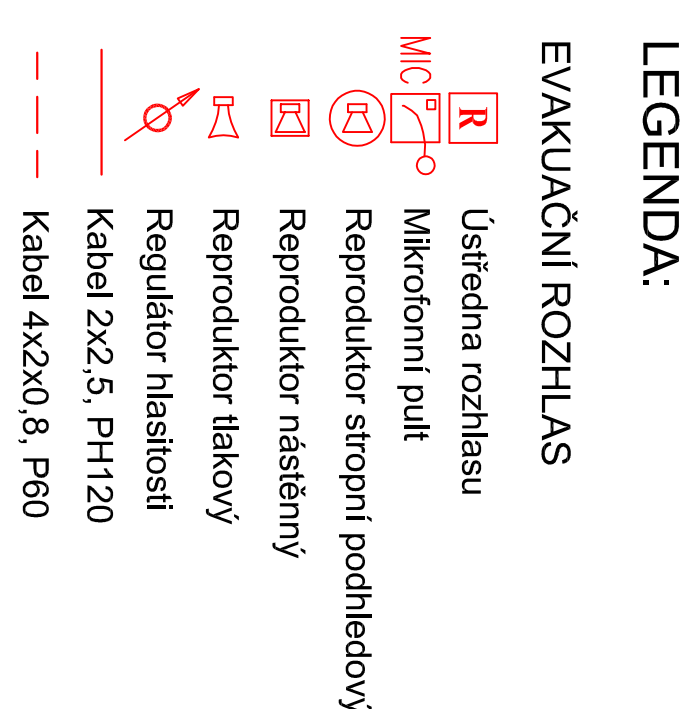

merit

MENTI GROUP S.S.
Biezinova 7
779 00 Okrouec
tel: +420 565 220 163
fax: +420 565 230 208
e-mail: menti@menti.cz