


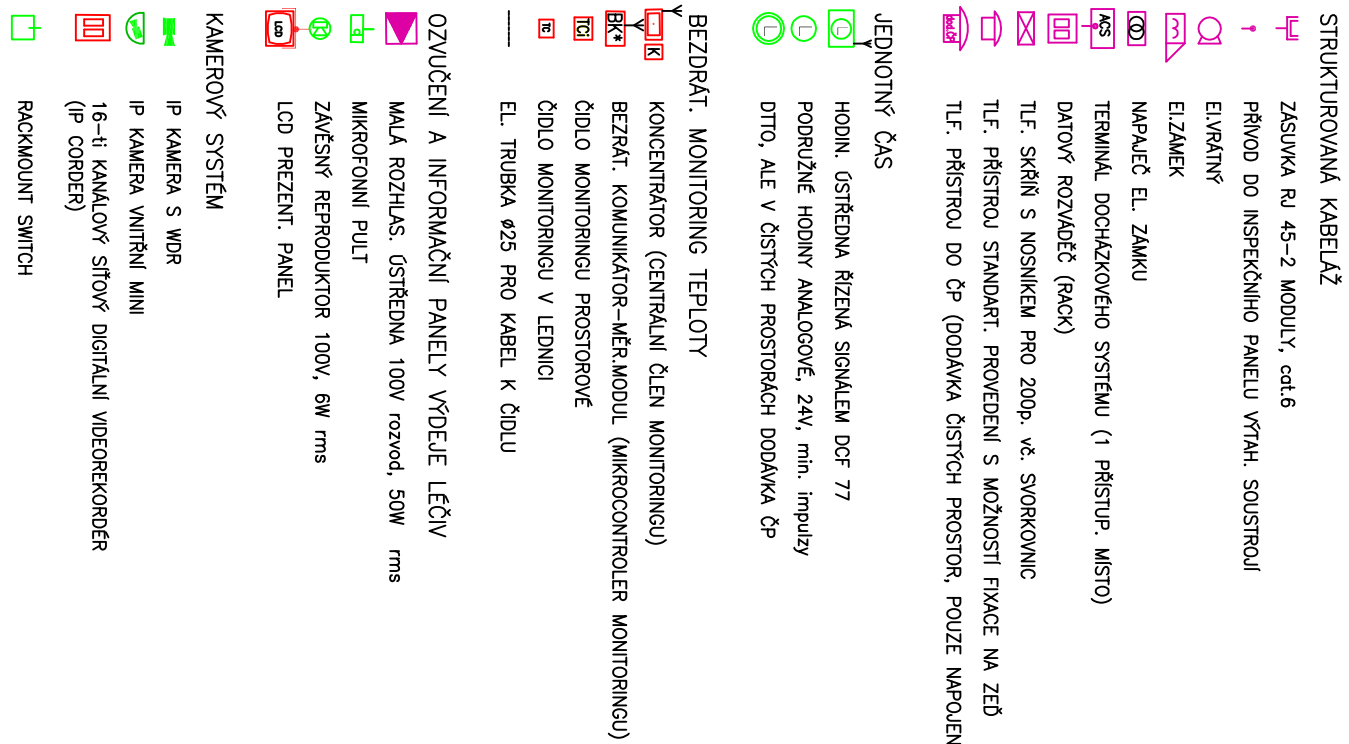

| |
|---|
| 6.1 | 6.2 | 6.3 | 6.4 | 6.5 | 6.6 | 6.7 | 6.8 | 6.9 | 6.10 | 6.11 | 6.12 | 10.50 |
| 6.1 | 6.2 | 6.3 | 6.4 | 6.5 | 6.6 | 6.7 | 6.8 | 6.9 | 6.10 | 6.11 | |

- 2 ▶ Trasa horizontální v ocelovém žlobu MMS 125x100 (max. 75x2 kob.UTP)
- 3 ▶ Trasa horizontální v ocelovém žlobu MMS 250x100 (max. 150x2 kob.UTP)
- 1s, 2s a 3s ▶ Dto, ale jako trasa sloupce

a.4.8.03